


ST 28

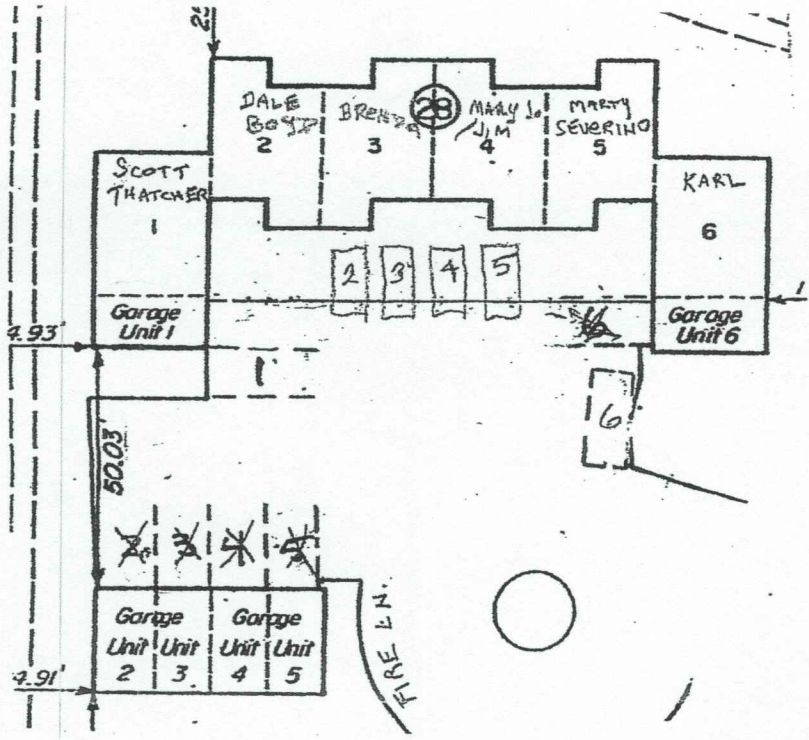

- \* NO HANDICAPPED PARKING NEEDED
- \* ALL 6 UNITS HAVE SPACE NOT BLOCKING GARAGE DOOR

SURVEYED & PLATTED  
BY  
**EVANS, MECHWART, HAMBLETON & TILTON, INC.**  
CONSULTING ENGINEERS AND SURVEYORS  
GAHANNA, OHIO

I hereby certify that the foregoing plat was prepared from an actual survey of the premises and shows the location of the boundaries and improvements as constructed and that there are no encroachments either way across the boundaries unless or except as shown hereon.

By Thomas D. Sibbalds  
Registered Surveyor No. 5908

SCALE: 1" = 40'

NOVEMBER, 1976

